


The image features a large, semi-transparent watermark in the center reading "ZMĚNA" on the left and "VÝPRAZDŇOVÁNÍ" on the right. Overlaid on this watermark is a detailed geological map of a mountainous region. The map includes several labels for settlements: "k.u. Krnčice" at the top, "k.u. Častohostice" on the right, and "k.u. Nové Syrovice" on the left. It also shows various geological zones and features, such as "WT HQ", "MN NS", "ZZ", "K 11-55", "AZ PZ", "DS PZ", "AZ DS", and "DS". A prominent red line runs through the upper part of the map, indicating a specific route or boundary. The background of the map is a light gray color.

# KOORDINAČNÍ VÝKRES

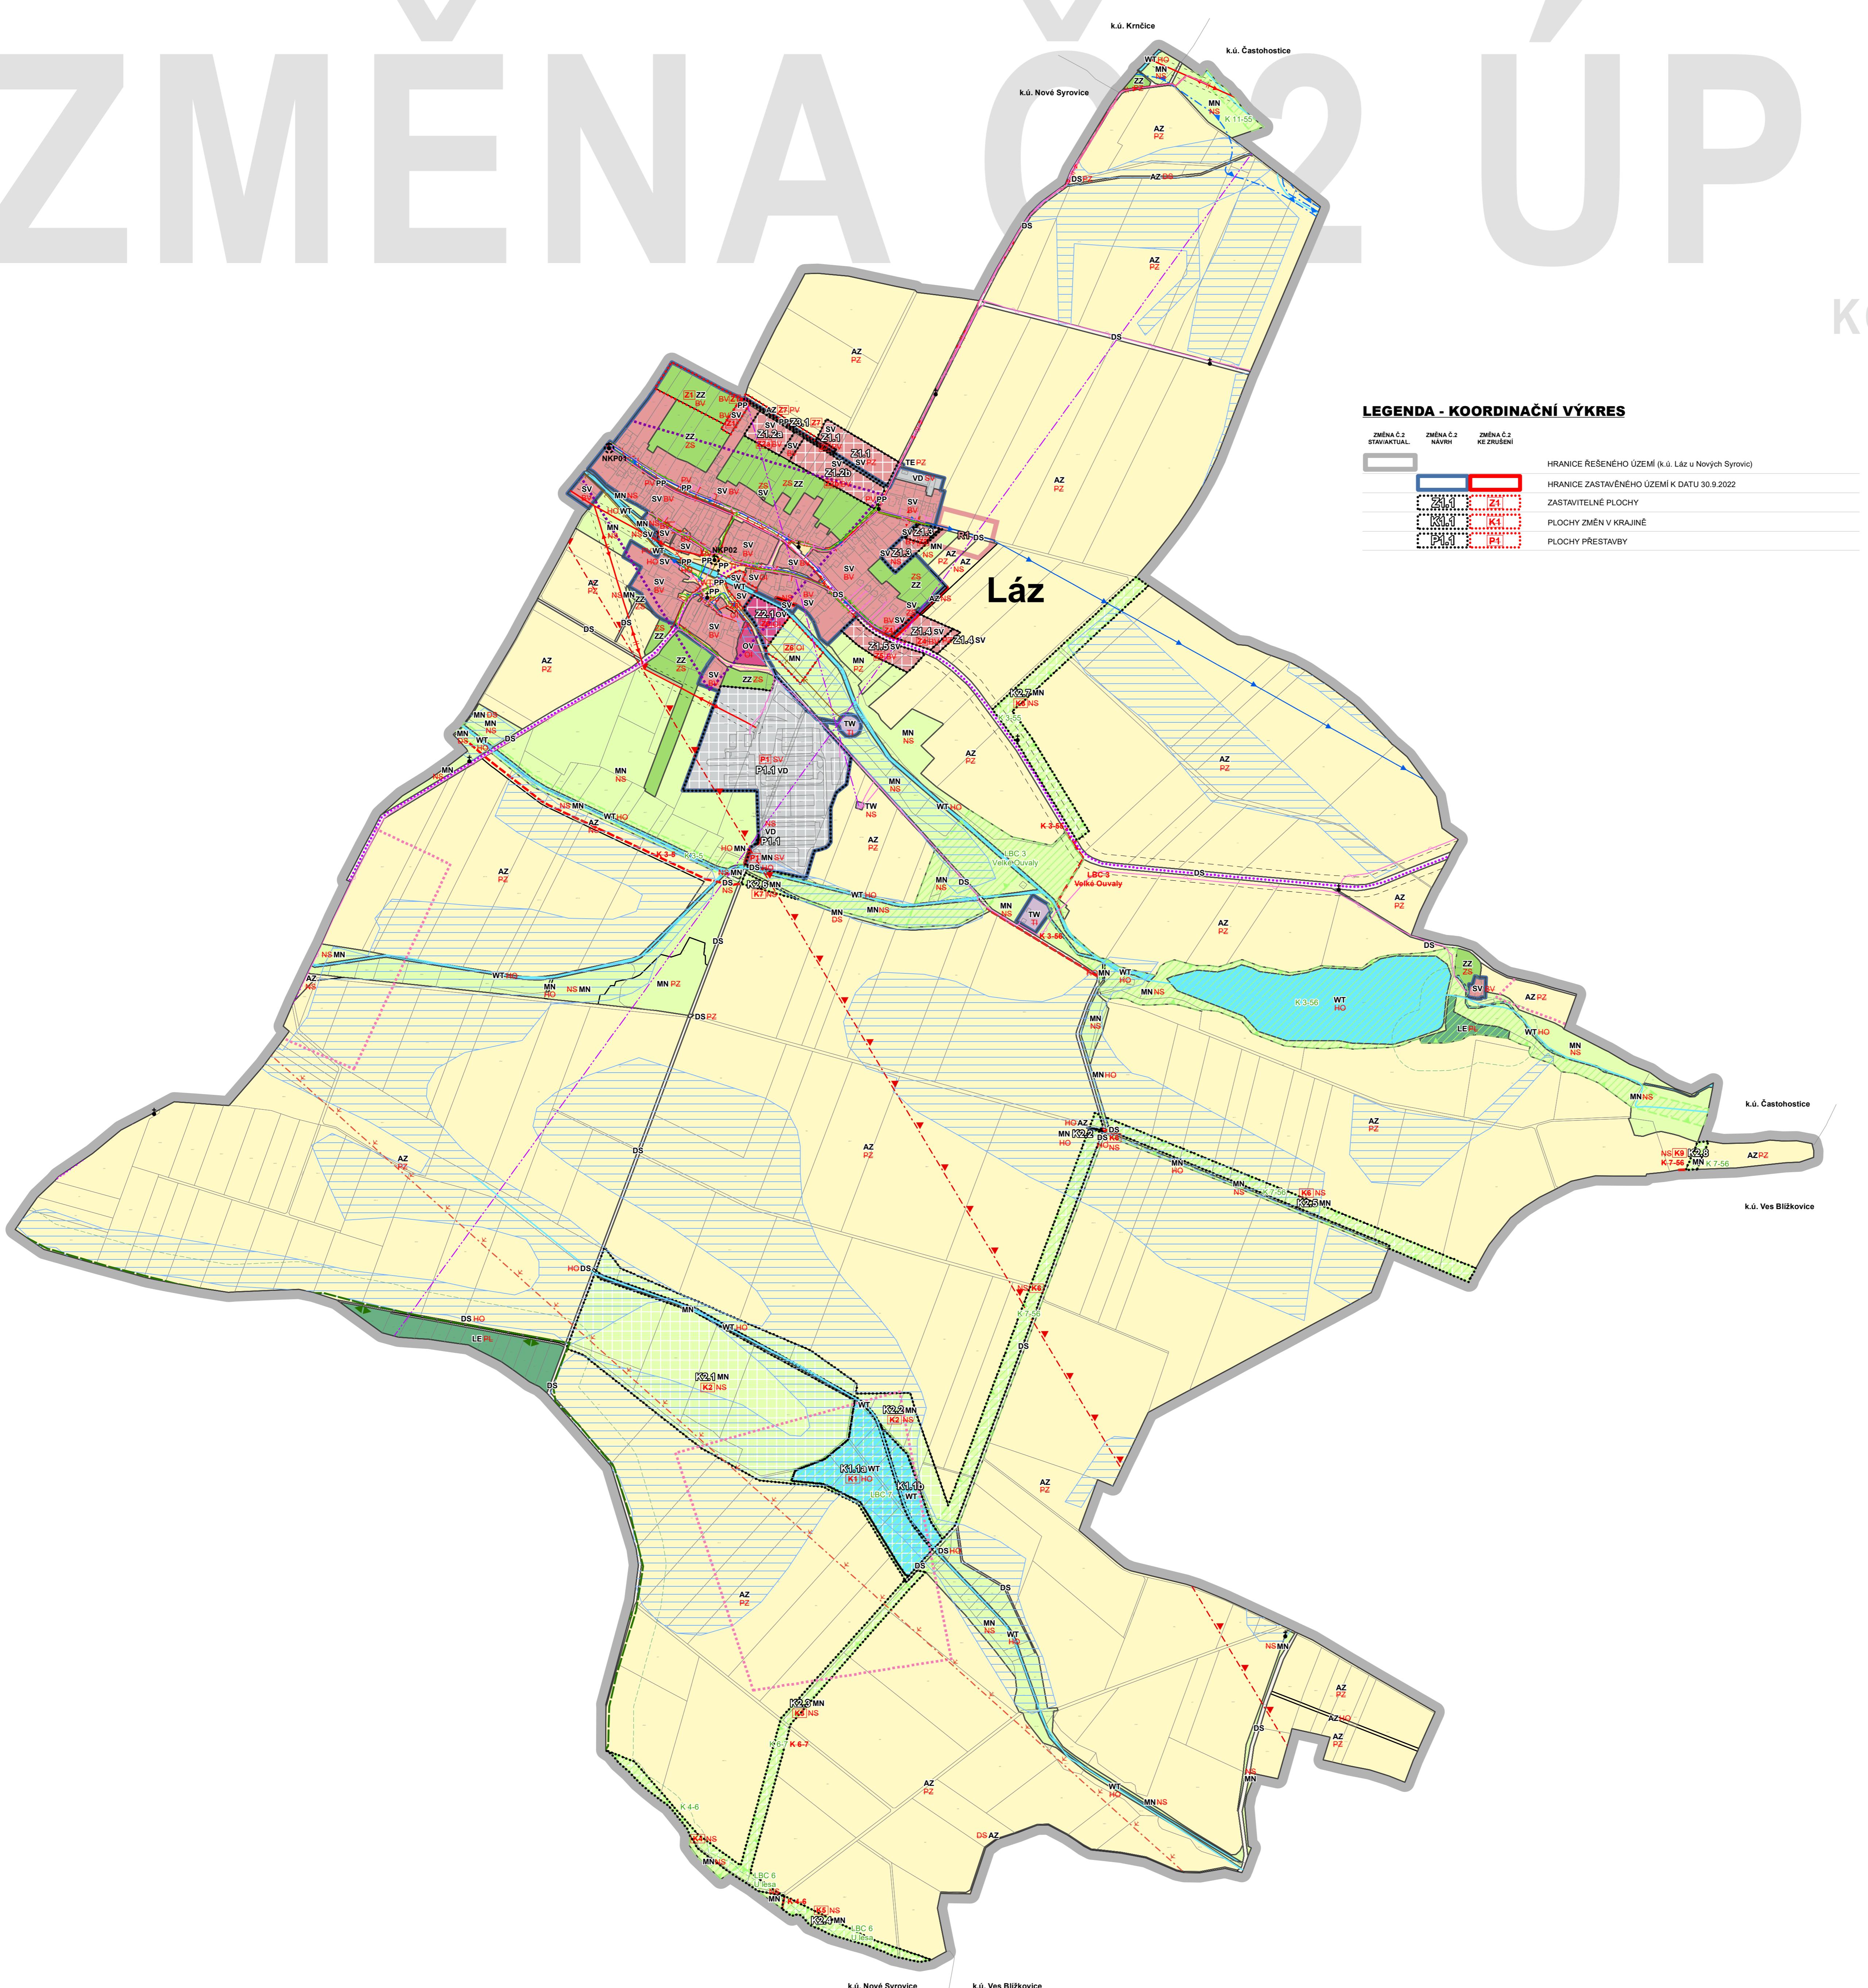

**DISprojekt s.r.o.**  
Havlíčkovo nábř. 131/37, 674 01 Třebíč  
IČO 60715227 DIČ CZ60715227  
E-MAIL: DISPROJEKT@VOLNY.CZ

E MAIL: DICK ROBERT@VCLNT.SZ  
TEL: +420 603 522 531

Ing. arch. Milan Grygar STUPEŇ: OOP

Ing. Lukáš Petr DATUM 06/2023

Ing. Lukáš Petr, Bc. Jan Grygar, Magdaléna Křivánková Č. ZAK. 07/2021  
Obrázek MĚŘÍTKO 1 : 5000

Obec Laz MĚRITKO 1 : 5000  
Městský úřad Moravské Budějovice, OVÚP

## **Změna č. 2 Územního plánu Lázní**

# **Změna c.z. Územního plánu Laz**

Koordináční výkres C. VÝKRESU 4